
LEGEND

- SANITARY SEWER (Gravity) — MANHOLE, CLEANOUT
- STORM SEWER — MANHOLE, 250 ø
- SANITARY SEWER (Forcemain)
- WATERMAIN — 200
- DUCT BANK – B.C. HYDRO, B.C.TEL. CABLEVISION & STREET LIGHTING — INDICATES CONCRETE ENCASEMENT
- OVERHEAD – " " " " " "
- MOUNTABLE CURB & GUTTER
- EDGE OF ASPHALT
- SANITARY SERVICE GRAVITY
- SANITARY SERVICE FORCEMAIN
- WATER SERVICE
- WATER VALVE
- FIRE HYDRANT
- CATCH BASIN
- B.C. TEL. & HYDRO CLUSTER OF SERVICE BOXES
- B.C. HYDRO JUNCTION BOX OR TRANSFORMER PAD.
- STREET LIGHT

} SEE SPECIFIC UTILITY DRAWINGS

- UTILITY POLE & ANCHOR

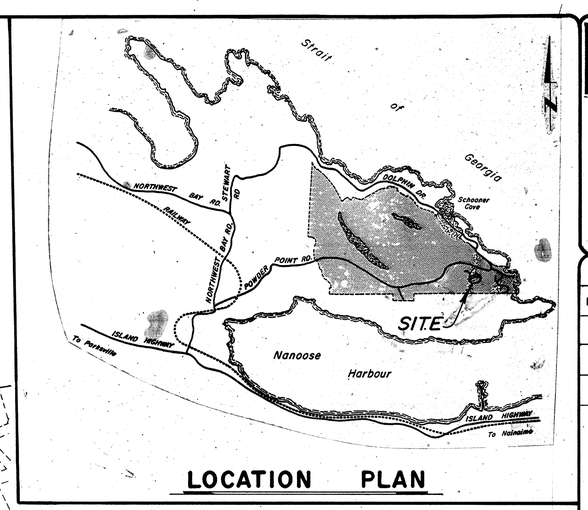

LOCATION PLAN

KEY PLAN

KOERS & ASSOCIATES ENGINEERING LTD.
Consulting Engineers

Fairwinds NANOOSE

REVISIONS

Nº	DATE	BY	ENG.	DESCRIPTION
1	APRIL 4/89	P.B.	OS	ISSUED FOR CONSTRUCTION
2	JULY 10/89	P.B	OS	AS CONSTRUCTED
3	AUG 10/89	J.R.	OS	AS CONSTRUCTED

PROJECT Nº D8707
DRAWN PRB
DESIGNED OS
CHECKED
APPROVED
DATE MARCH 8, 1989
SCALE: 1 : 5000
CLIENT:

FAIRWINDS JOINT VENTURE

PROJECT

FAIRWINDS DEVELOPMENT
PHASE II a
ROADS & UTILITIES


FW-058

TITLE

KEY & LOCATION PLANS
LEGEND & TYPICAL NOTES

FW-058

DRAWING Nº	REV.	SHEET
D8707 - 83	3	1/11

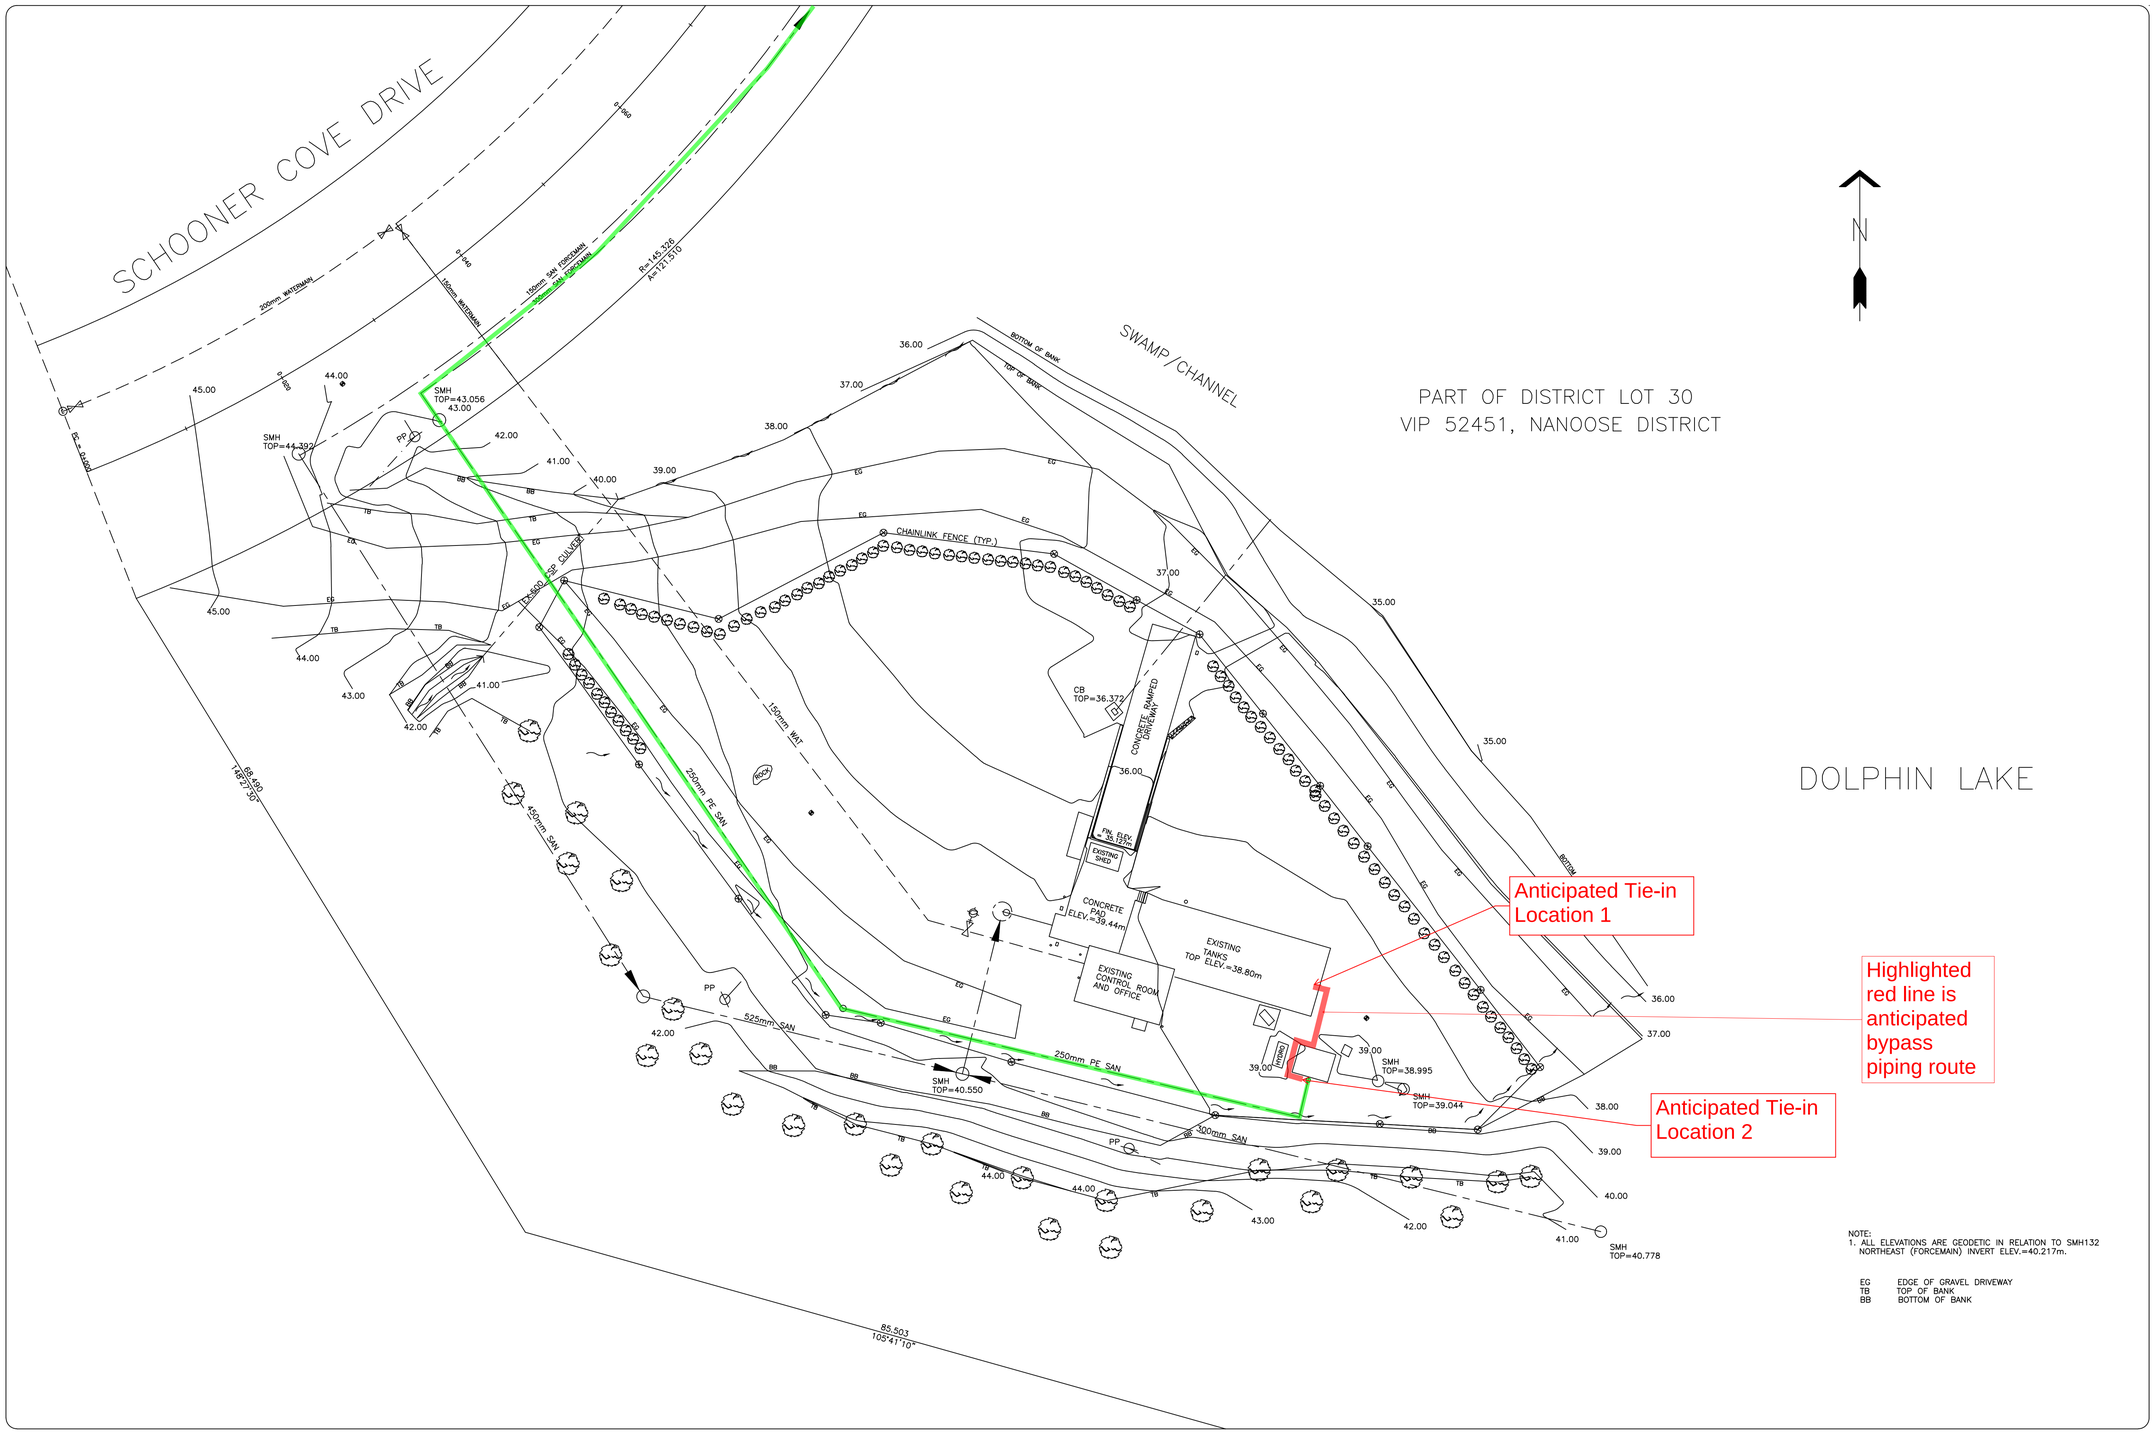

NOTE:
1. ALL ELEVATIONS ARE GEODETIC IN RELATION TO SMH132 NORTHEAST (FORCEMAIN) INVERT ELEV.=40.217m.

EG EDGE OF GRAVEL DRIVEWAY
TB TOP OF BANK
BB BOTTOM OF BANK

Prepared by
V. ROBERTS & ASSOCIATES LTD.
CONSULTING ENGINEERS
CIVIL • MUNICIPAL • LAND DEVELOPMENT • FORESTRY
852 BREAKWATER ROAD, PARKSVILLE, B.C. V9P 1Z8
TEL/FAX (250) 248-3580 e-mail: vroberts@island.net

Design by V.R. Date
Drawn by V.R. APRIL 1999 Date
Checked by Date
Approved by Date
Seal

No.	Date	Revisions	By

Client
REGIONAL DISTRICT OF NANAIMO

Location
PART OF D.L.30
VIP 52451, NANOOSE DISTRICT

Legend :
Hydrant with Valve
Utility Pole
Survey Monument
Ditch
Fence
Lot Line
Street Light
P.P. or T.P.
WATER
SANI
STORM
HYDRO
TEL
CABLE
GAS
EXISTING PROPOSED EXISTING PROPOSED
See also Municipal standards

Project
FAIRWINDS SEWAGE TREATMENT PLANT

Title
SITE TOPOGRAPHIC SURVEY

Municipal or District Project No.

Scale
Horiz. 1:250 Vert

Municipal or District Drawing No.
NB-C-103

Consultant's Drawing No.
61-001-1
Sheet No. Rev.